


**SECOND FLOOR PLAN**  
SCALE: 1/8" = 1'-0"

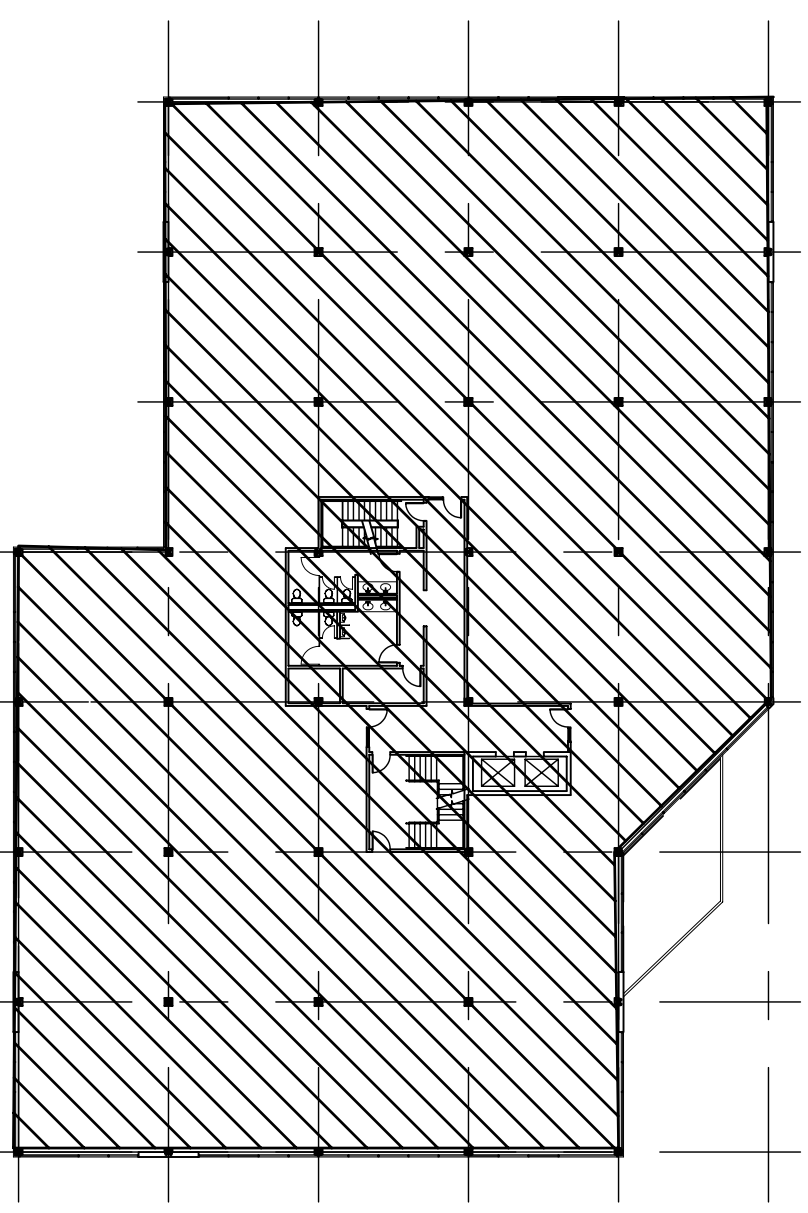

**2ND FLOOR LOCUS PLAN**  
SCALE: 1/32" = 1'-0"

<p>DATE: 91 JUL 2006</p> <p><b>X2</b></p>	<p>EXISTING FLOOR PLAN</p>	<p><b>BERARD-MARTEL</b> ARCHITECTURE, INC.</p> <p>170 SOUTH RIVER ROAD BEDFORD, NEW HAMPSHIRE 03110 (603) 626 7903 FAX (603) 626 4433</p>	<p>LIGHTSHIP BLDG 1 SECOND FLOOR</p> <p>BEDFORD, NH</p>	<p>NO. REVISION</p>
	<p>NORTHLAND INVESTMENTS</p>			